

NOTE:
DRAWINGS ON MAJOR MACKENZIE DRIVE
TAKEN FROM DWG. No. T-12-010873
SHEET No. 10 AND 48
(AS PER EMAIL RECEIVED 14-08-2014)

LEGEND

210.02	DENOTES PROPOSED ELEVATION
211.0	DENOTES EXISTING ELEVATION
208.00	DENOTES EXISTING CONTOUR ELEVATION
208.00	DENOTES FUTURE CENTRELINE ELEVATION
200.55W	DENOTES PROPOSED ELEVATION
200.55SW	DENOTES SWALE
---	DENOTES REGIONAL WATER LEVEL
---	DENOTES 100 YR. WATER LEVEL
---	DENOTES PERMANENT POOL LEVEL
---	DENOTES PROPOSED POOL CONTOUR LINE
---	DENOTES RIP-RAP STONE
---	DENOTES SCOURSTOP
---	DENOTES TEMPORARY DIVERSION ROAD TAKEN FROM AECOM DRAWINGS

AS CONSTRUCTED OCTOBER 2019

No.	DESCRIPTION	By	Date
1	UPDATES TEMPORARY SWM POND DRAWING DESIGN IN ACCORDANCE WITH PRELIMINARY GEOTECHNICAL REPORT AND SOILS DATA REPORT.	R.M.	04-20-15
2	RECORD UPDATED AS PER AS BUILT INFO	A.R.	DEC. 2017
3	AS CONSTRUCTED	R.D.	DEC. 2017
4	AS CONSTRUCTED	R.M.	01/14/2020

BENCH MARK No. 60-2
THREE HYDRO TOWERS ON NORTH SIDE OF RUTHERFORD ROAD, 0.4 KM EAST OF HUNTINGTON ROAD. TOP SOUTH-WEST CONCRETE BASE ON LEG #10 TOWER. 0.20m SOUTHEAST AND 0.35m OF STEEL FOOT PLATE. ELEVATION OF 185.009 METRES.

BENCH MARK No. 64-3
0.6m NORTH OF WEST LEG OF LANEFARF ROAD, WEST SIDE OF HUNTINGTON ROAD. TRAINING AND REHABILITATION CENTRE. LULUKA LOCAL 183, SOUTH-EAST CORNER AND 0.10m ABOVE WALK ON SOUTH FACE. ELEVATION OF 197.218 METRES.

BENCH MARK No. 66-2
HYDRO TOWER 0.5m WEST OF HUNTINGTON ROAD ON NORTH SIDE OF MAJOR MACKENZIE DRIVE. MOST EASTERN HYDRO TOWER IS APPROXIMATE 180m NORTH OF MAJOR MACKENZIE DRIVE SOUTH-EAST CORNER OF CONCRETE BASE OF LEG #8 TOWER. ELEVATION OF 204.731 METRES.

PROFESSIONAL ENGINEER
M. NIKOVIC
2017-2019
PROVINCE OF ONTARIO

FOR PHASE 2 ONLY

ANDREW D. PEARCE, C.E.T., MARCH 5, 2019
DIRECTOR OF DEVELOPMENT
MUNICIPALITY OF MISSISSAUGA

NASHVILLE DEVELOPMENTS INC.
NASHVILLE HEIGHTS RESIDENTIAL SUBDIVISION
PHASE 2

SCHAEFFERS
CONSULTING ENGINEERS & ARCHITECTS
Ontario 148, 4th Fl.
Tel: (905) 738-1100
Fax: (905) 738-4875
Email: design@schaffers.com

PROJECT No.	2012-3921	DRAWING No.	SWM-1
SCALE	0 5 10 15 20 25 30 35 40 45 50m		

VAUGHAN

PHASE 1 SWM POND (TEMPORARY)

D19 10.00BV 65M-4489 19T-10V004

DESIGNED BY: A.O. DATE: NOVEMBER 2014 CHECKED BY: M.N.
DRAWN BY: R.M.M. APPROVED BY: P.S.
SCALE: 1:500 DWG. No.

NOTES:

- THE LOCATION OF ALL UNDERGROUND AND ABOVE GROUND UTILITIES AND STRUCTURES IS NOT NECESSARILY SHOWN ON CONTRACT DRAWINGS, AND WHERE SHOWN THE LOCATION AND ELEVATION OF SUCH UTILITIES AND STRUCTURES IS NOT GUARANTEED. PRIOR TO COMMENCING CONSTRUCTION, THE CONTRACTOR SHALL VERIFY EXACT LOCATION AND ELEVATION OF SUCH UTILITIES AND STRUCTURES AND SHALL ASSUME ALL LIABILITY OF DAMAGE TO ADJACENT UTILITIES AND STRUCTURES DURING CONSTRUCTION OF SERVICES TO BE PROVIDED.
- ALL AREAS DISTURBED DURING CONSTRUCTION OF SERVICES TO BE PROVIDED SHALL BE RESTORED OR BETTER, TO THE SATISFACTION OF THE CITY OF MISSISSAUGA AND REGION OF YORK ENGINEERING DEPARTMENT. GRAZED AREAS TO BE TOPPED WITH 100mm TOPSOIL, AS PER OF THE CITY OF MISSISSAUGA. EXISTING SERVICES TO BE ADJUSTED TO SUIT NEW GRADES.
- CUT AREAS OF POND AND FOREBAY TO BE INSPECTED BY THE GEOTECHNICAL INSPECTOR FOR ADVICE ABOUT THE TYPE OF EROSION PROTECTION NEEDED.
- ALL TOPSOIL AND ORGANIC MATERIALS FROM POND AREAS TO BE STRIPPED BEFORE PLACING ANY FILL.
- ALL EXISTING STRUCTURES, DRIVEWAYS, CULVERTS, BRIDGES TO BE REMOVED AND DISPOSED OFF SITE.
- POND SHALL BE STABILIZED IMMEDIATELY IN TERRACING AND SLOPE UP SEEDING AS REQUIRED.
- IF SAND WAS ENCOUNTERED DURING CONSTRUCTION OF POND, THE UPPER LAYER OF THE SIDE SLOPE AND THE BOTTOM OF THE POND SHALL BE REPLACED WITH A LAYER OF SILENT CLAY FILL MATERIAL, THICKNESS TO BE DETERMINED BY SOIL CONSULTANT COMPACTED TO 95% OF A STANDARD PROCTOR DRY DENSITY. AN INTERCEPT SUBDRAIN SYSTEM (SEE DETAIL) SHOULD ALSO BE CONSTRUCTED TO STABILIZE THE SIDE.
- ASPHALT APRON BETWEEN STREET CURBS AND SIDEWALK SHALL BE HEAVY DUTY ASPHALT.
-50mm COMPACTED DEPTH H-3 ASPHALT TOP COURSE
-75mm COMPACTED DEPTH H-6 ASPHALT BASE COURSE
-150mm COMPACTED DEPTH OF 20mm DIAMETER CRUSHER RUN LIMESTONE
-300mm COMPACTED DEPTH OF 20mm DIAMETER CRUSHER RUN LIMESTONE

DESCRIPTION	PROVIDED STORAGE	REQUIRED STORAGE
PERMANENT POOL EL. 199.20-200.50	3,510m ³	2,964m ³
QUALITY EROSION EL. 200.50-201.15	2,918m ³	2,798m ³
2 YR. W.L. EL. 200.50-201.30	3,729m ³	3,140m ³
5 YR. W.L. EL. 200.50-201.45	4,600m ³	4,012m ³
10 YR. W.L. EL. 200.50-201.60	5,865m ³	4,710m ³
25 YR. W.L. EL. 200.50-201.75	6,568m ³	5,594m ³
50 YR. W.L. EL. 200.50-201.85	7,331m ³	6,342m ³
100 YR. W.L. EL. 200.50-202.00	8,180m ³	7,125m ³

APPLICATION METHOD: TERRACING BY APPROVED CONTRACTOR
SEED MIX TYPE "A" TO BE USED IN VALLEY AREAS ON SLOPES & UPLAND


CUSTOM MIX MEADOW MIX BY ONTARIO SEED COMPANY (519) 886-0557 OR APPROVED EQUAL

20% BIG BLUE STEM (ANDROPOGON GERARDI)
20% LITTLE BLUE STEM (ECHINOCHLOA SCOPARIUS)
20% FOL SEED (CAREX MURICOLA)
20% CANADIAN MID PINE (ELMUS CANADENSIS)
20% POCKET PINE GRASS (SPOONWOOD SPECIES)
10% SEED RATE: 200kg/ha

SEED MIX TYPE "B" TO BE USED IN VALLEY AREAS IN THE FLOOD PLAIN

CUSTOM MIX MEADOW MIX BY ONTARIO SEED COMPANY OR APPROVED EQUAL

10% JOE PEE WEED (EUPHORBIA MACULATA)
10% CANADA BLUEBENT (CALAMAGROSTIS CANADENSIS)
10% FOL SEED (CAREX MURICOLA)
10% SOFT RUSH (JUNCUS EFFUSUS)
10% JOINTED RUSH (CAREX MURICOLA)
10% FORTYONE SEED (CAREX HYSTERICINA)
10% BLUE STERNON (GERARDIA HASTATA)
10% SEED AT 200kg/ha

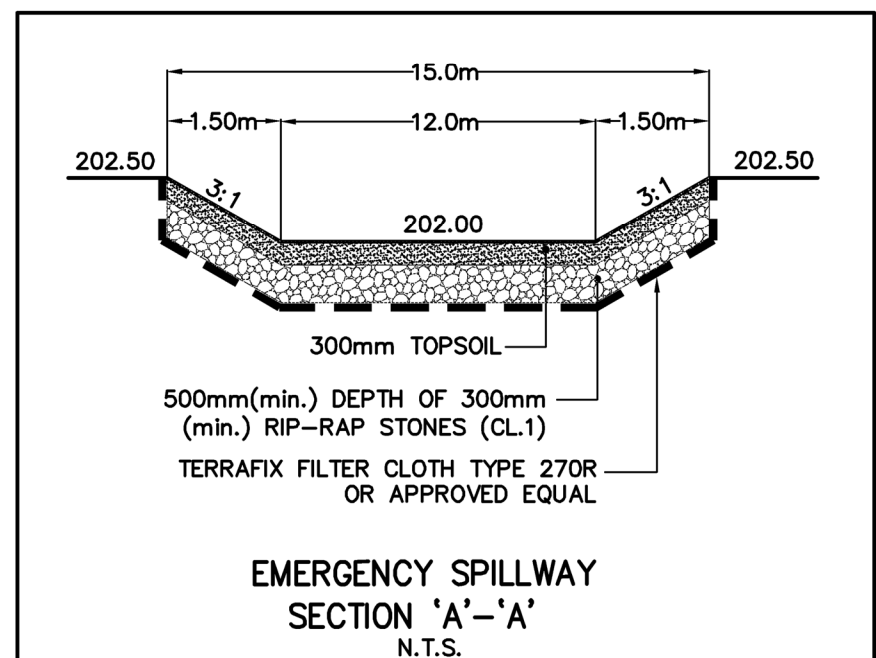

SPECIFICATION FOR CLASS I RIP-RAP STONE:

100% SMALLER THAN 450mm OR 130kg
at least 20% LARGER THAN 350mm OR 70kg
at least 50% LARGER THAN 300mm OR 40kg
at least 80% LARGER THAN 200mm OR 10kg

REFER TO:

DWG. No. SWM-2 FOR SECTIONS 1-1 TO 4-4
DWG. No. SWM-3 FOR SECTIONS 5-5 TO 7-7
DWG. No. SWM-4 FOR SECTION 8-8 AND STANDARD DETAILS
DWG. No. SWM-5 FOR CONTROL FLOW STRUCTURE DETAIL
DWG. No. SWM-6 FOR STORM OUTFALL DETAILS 900mm CONCRETE PIPE
DWG. No. SWM-7 FOR STORM MH-100B DETAILS 3000mm x 3800mm PRECAST MH